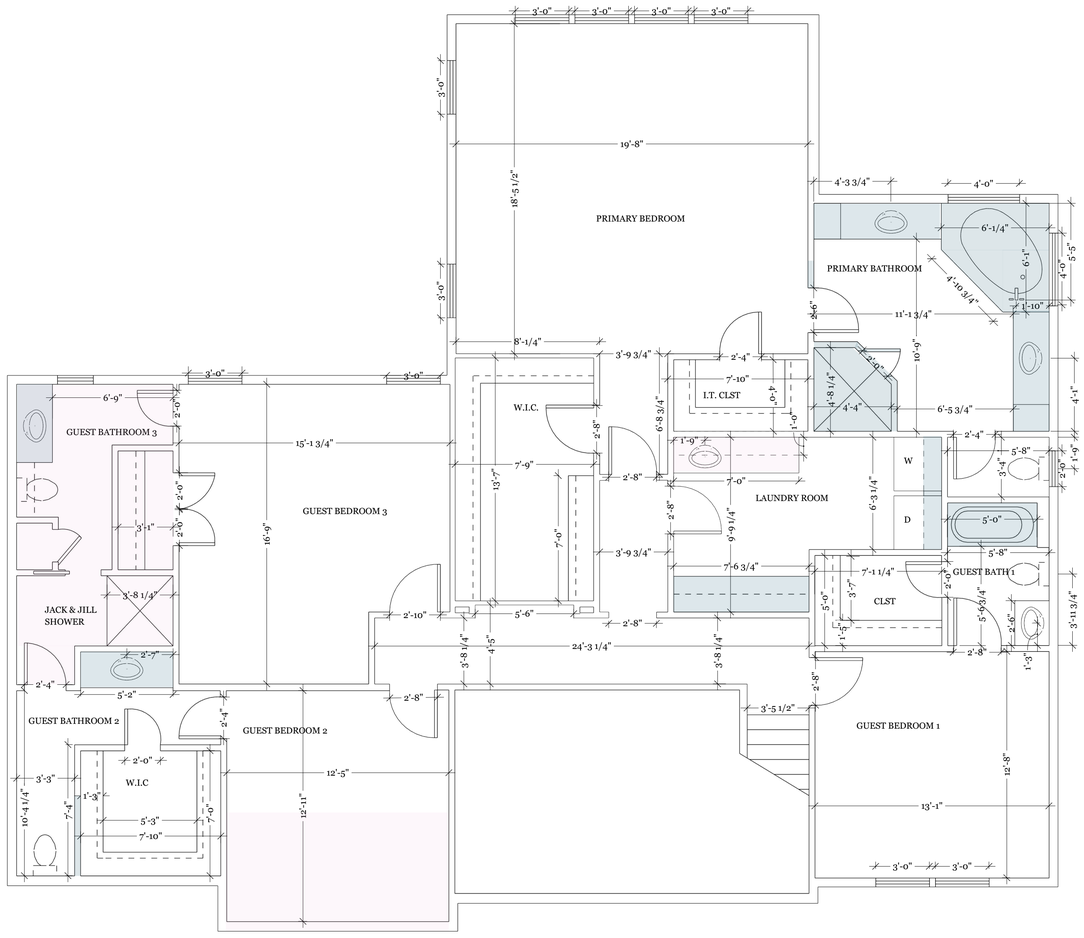


A.2 AS-BUILT- LEVEL 2

Scale: 1/4"

TO BE DEMOLISHED

DIMENSIONS NEED CONFIRMING

DESIGNS UNLIMITED
P.O. BOX 12546,
Tallahassee, FL 32317
850-296.2430
www.designsunlimitedusa.com

ISSUE
7.2.26

DRAWN BY
JLM, MKB

CLIENT
MCKERVEY

5008 VELDA DAIRY RD
TALLAHASSEE, FL 32309

AS BUILT

LEVEL 2

FLOOR PLAN

Before starting construction, the builder/contractor shall review, and be responsible for all the details, dimensions, structure, components, building code requirements, and engineering specifics. Geographical and jurisdictional building customs shall supersede specifications contained herein.

A 2